

Clinton County Engineer's

Record of Land Surveys


File Date: 11-07-90

Scale:


Dead Reference:

Book: Page:


RECEIVED FOR RECORD
 Recorded: Dec. 7, 1990
 Book No. 7 Page: 22 D
 # 5095
 Fee: \$10.00
 JEAN S. RICHARDSON
 Recorder
 Clinton County, Ohio

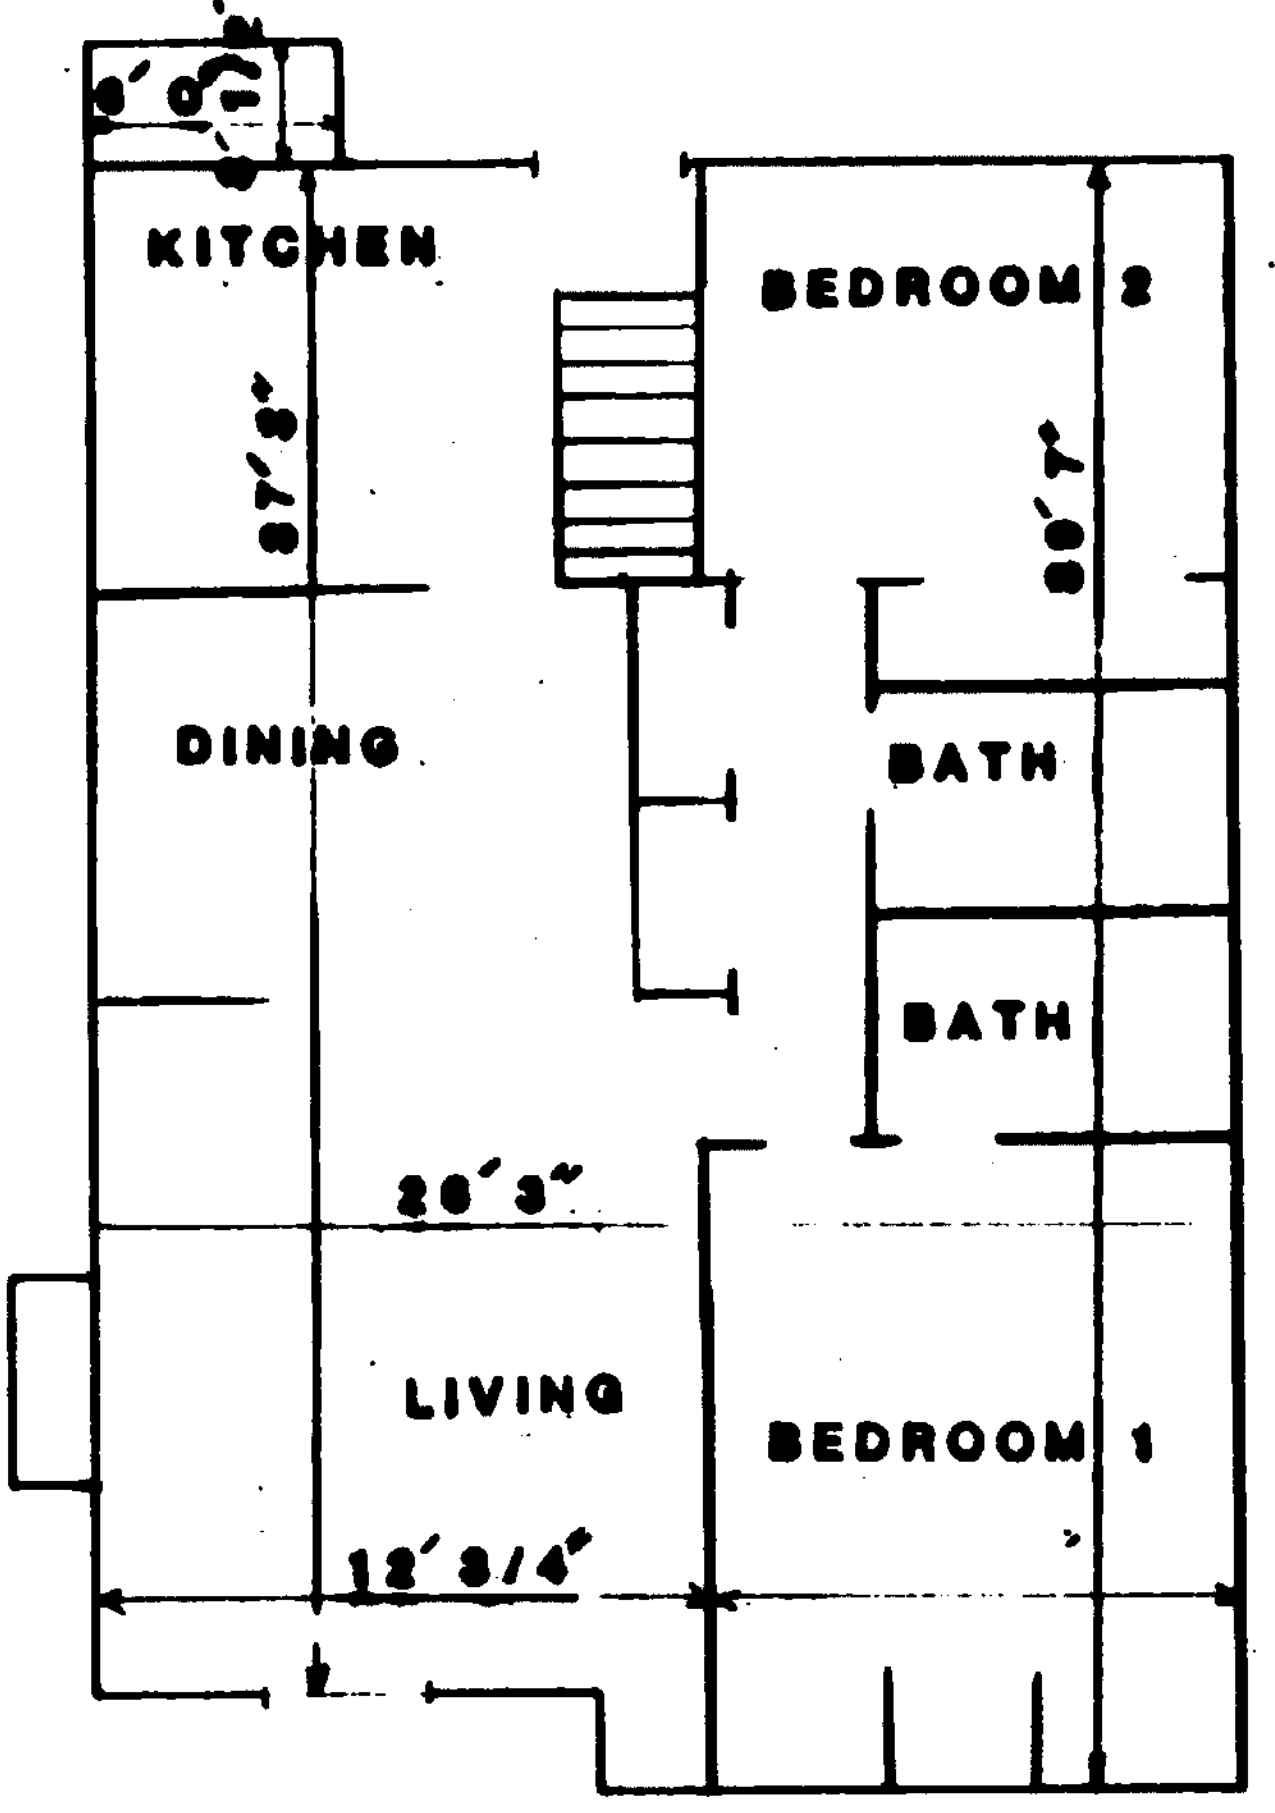

First Floor

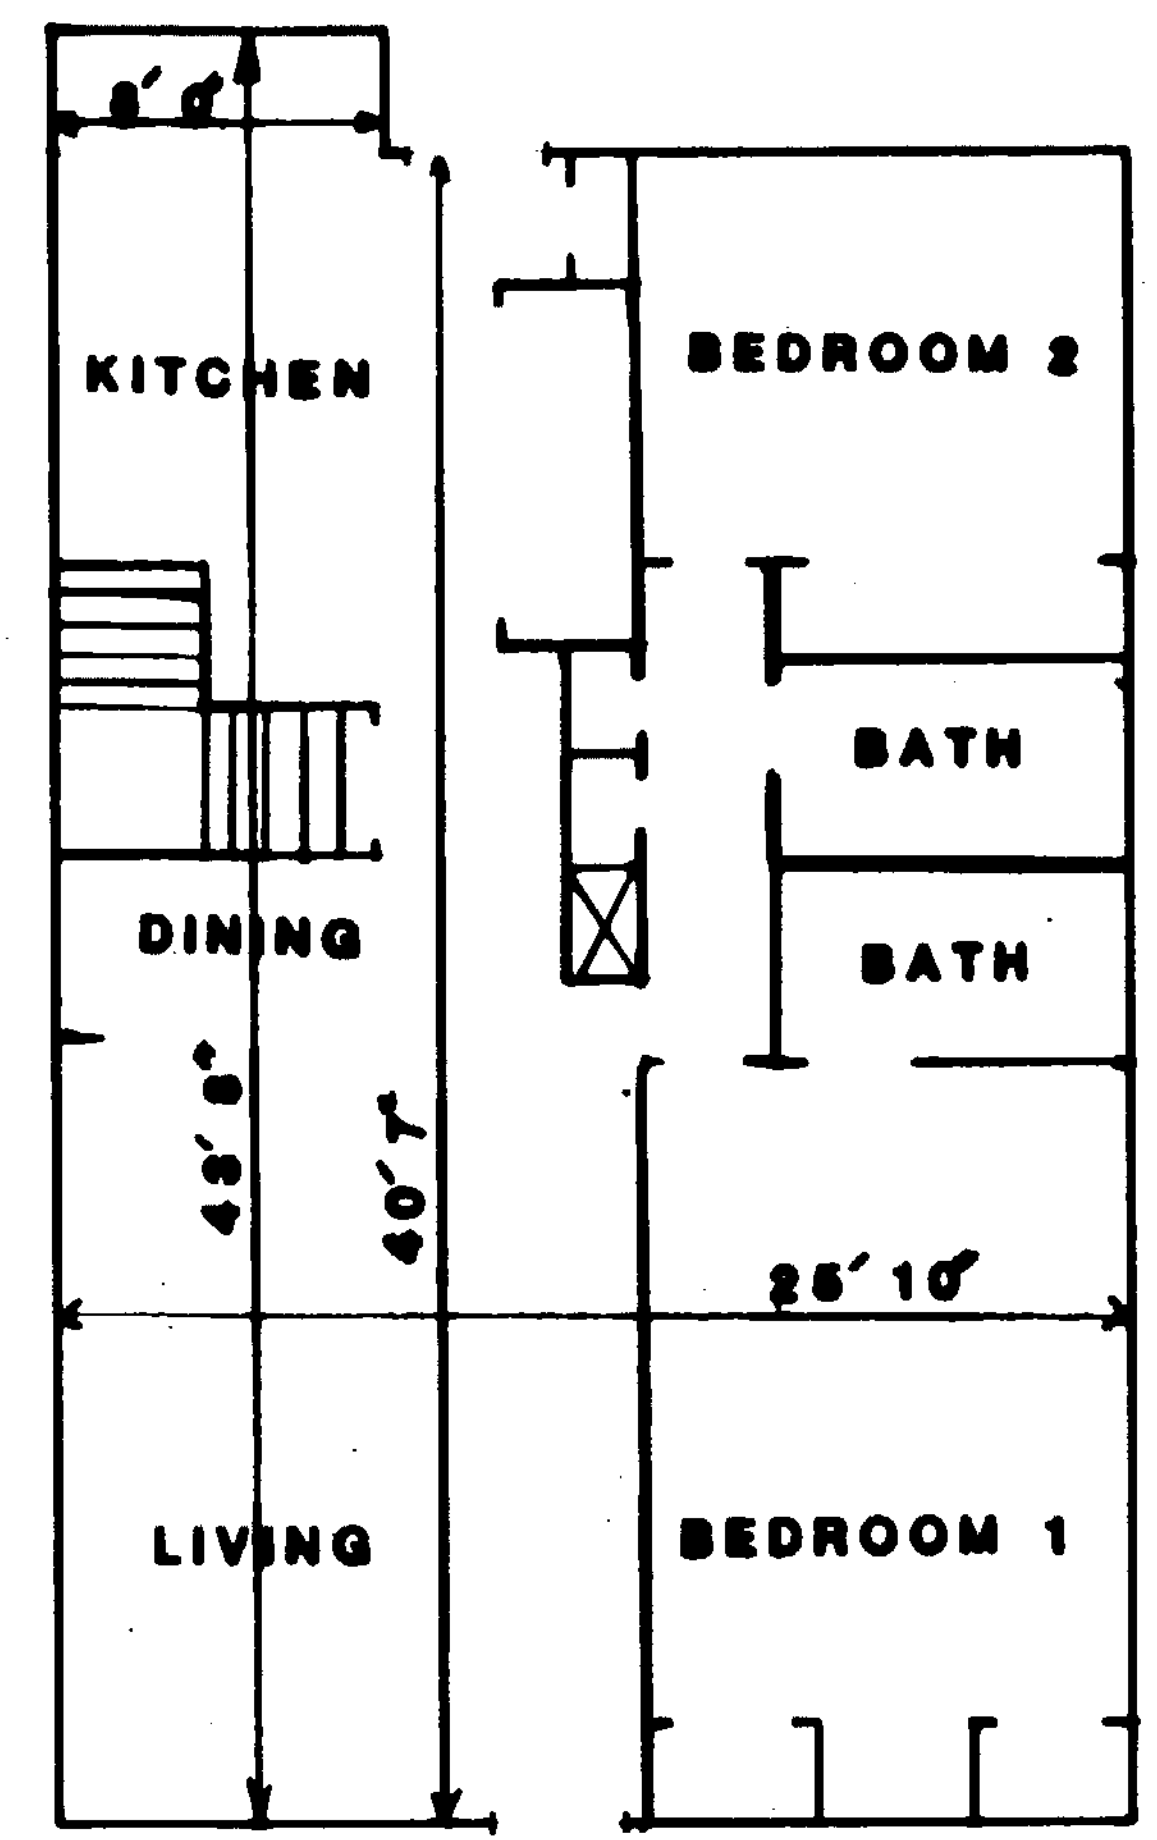


First Floor

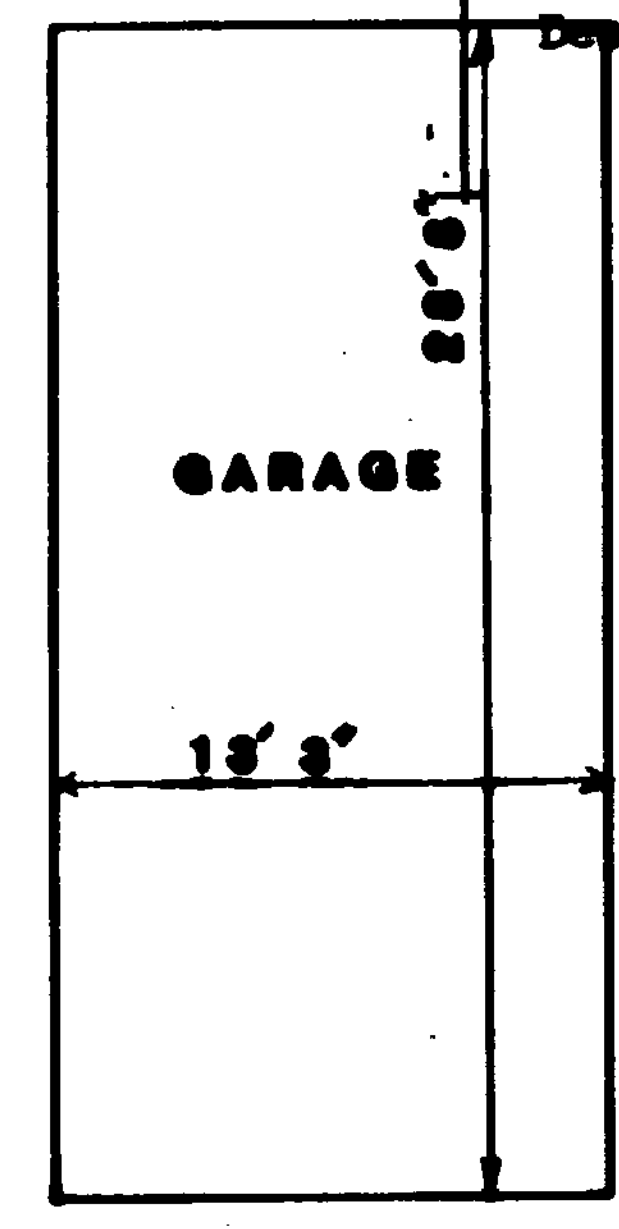


Garage

Per Plan For Units 28, 29, 34

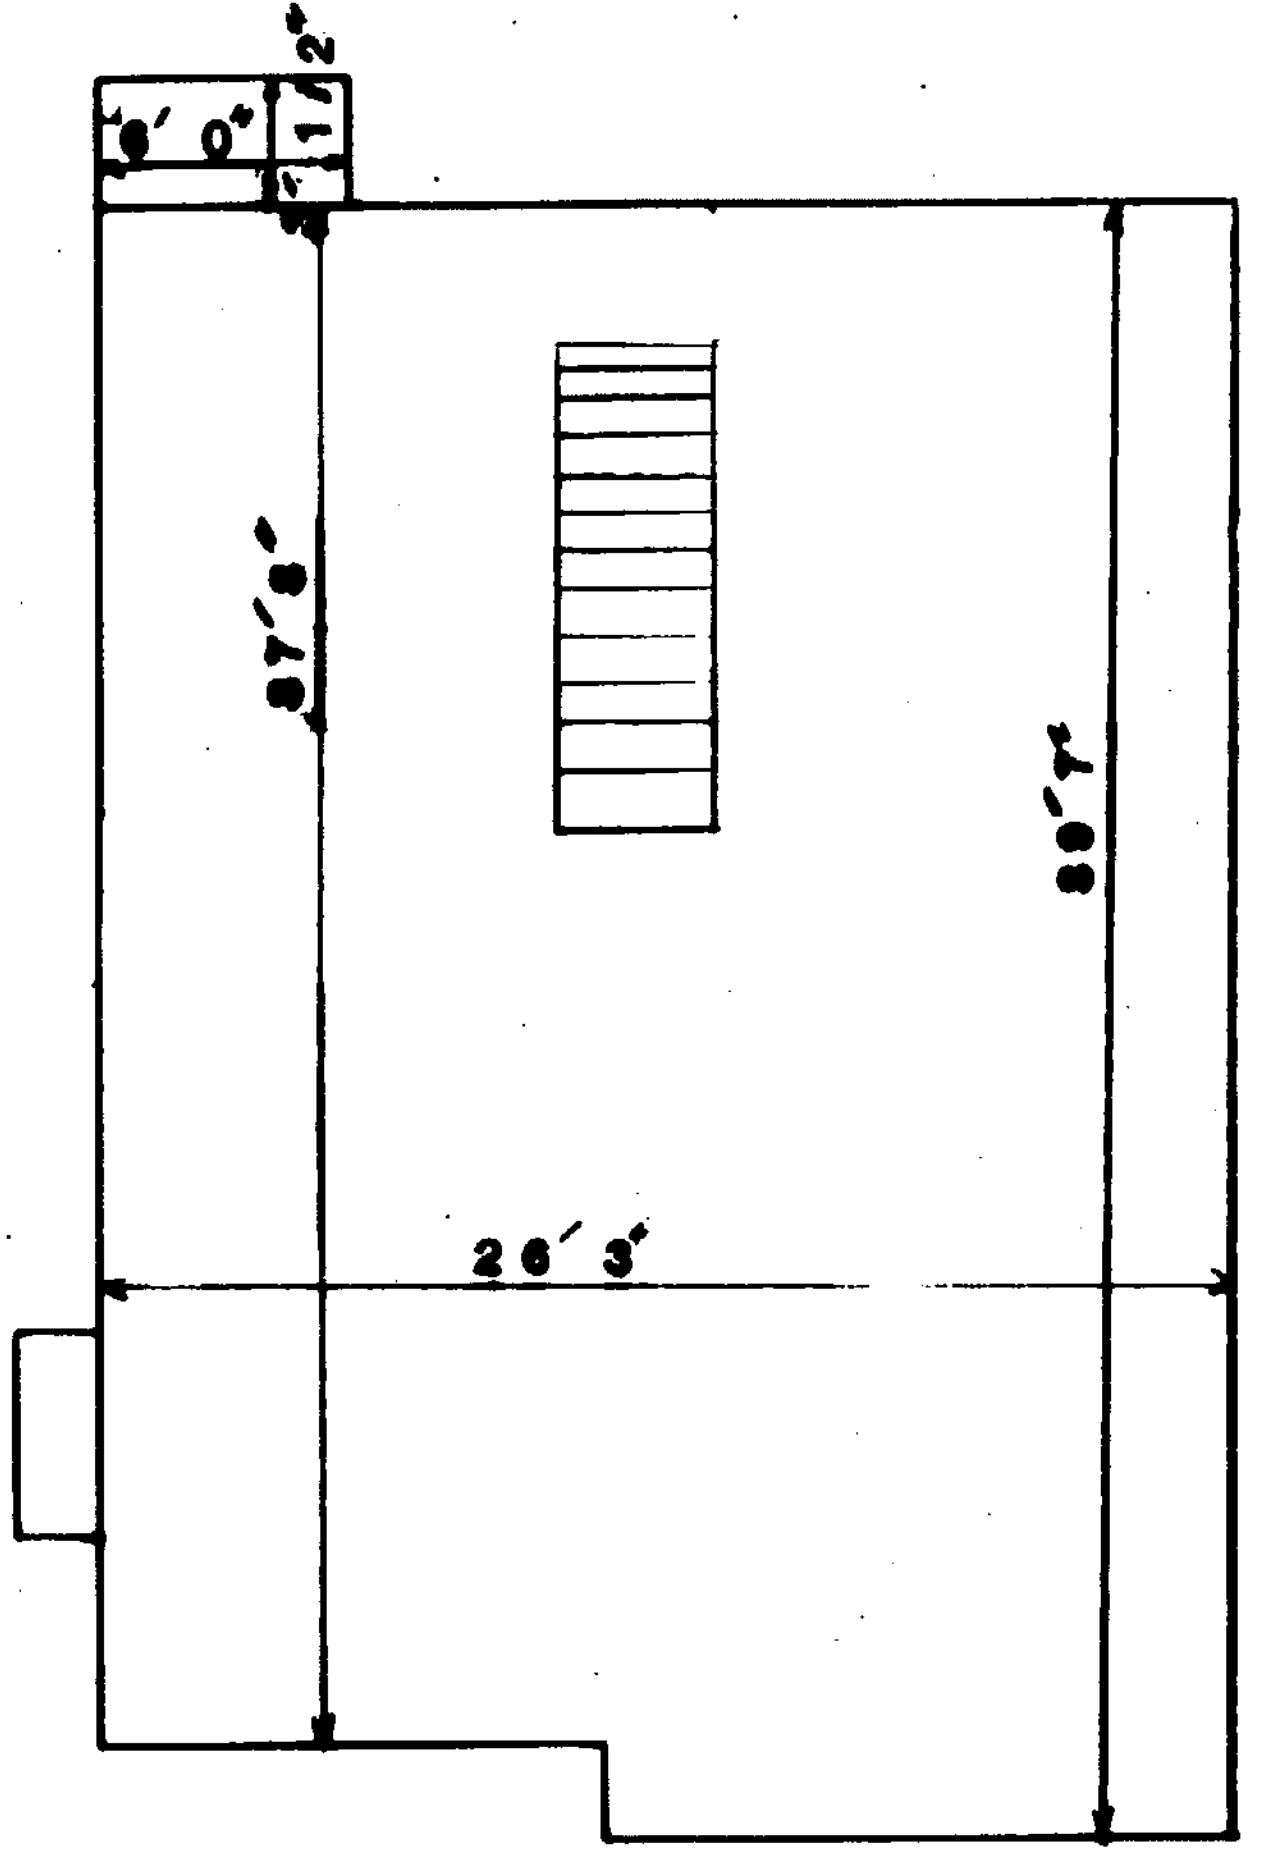

Basement

Per Plan For Unit 21
 Reverse or Mirror For Unit 19

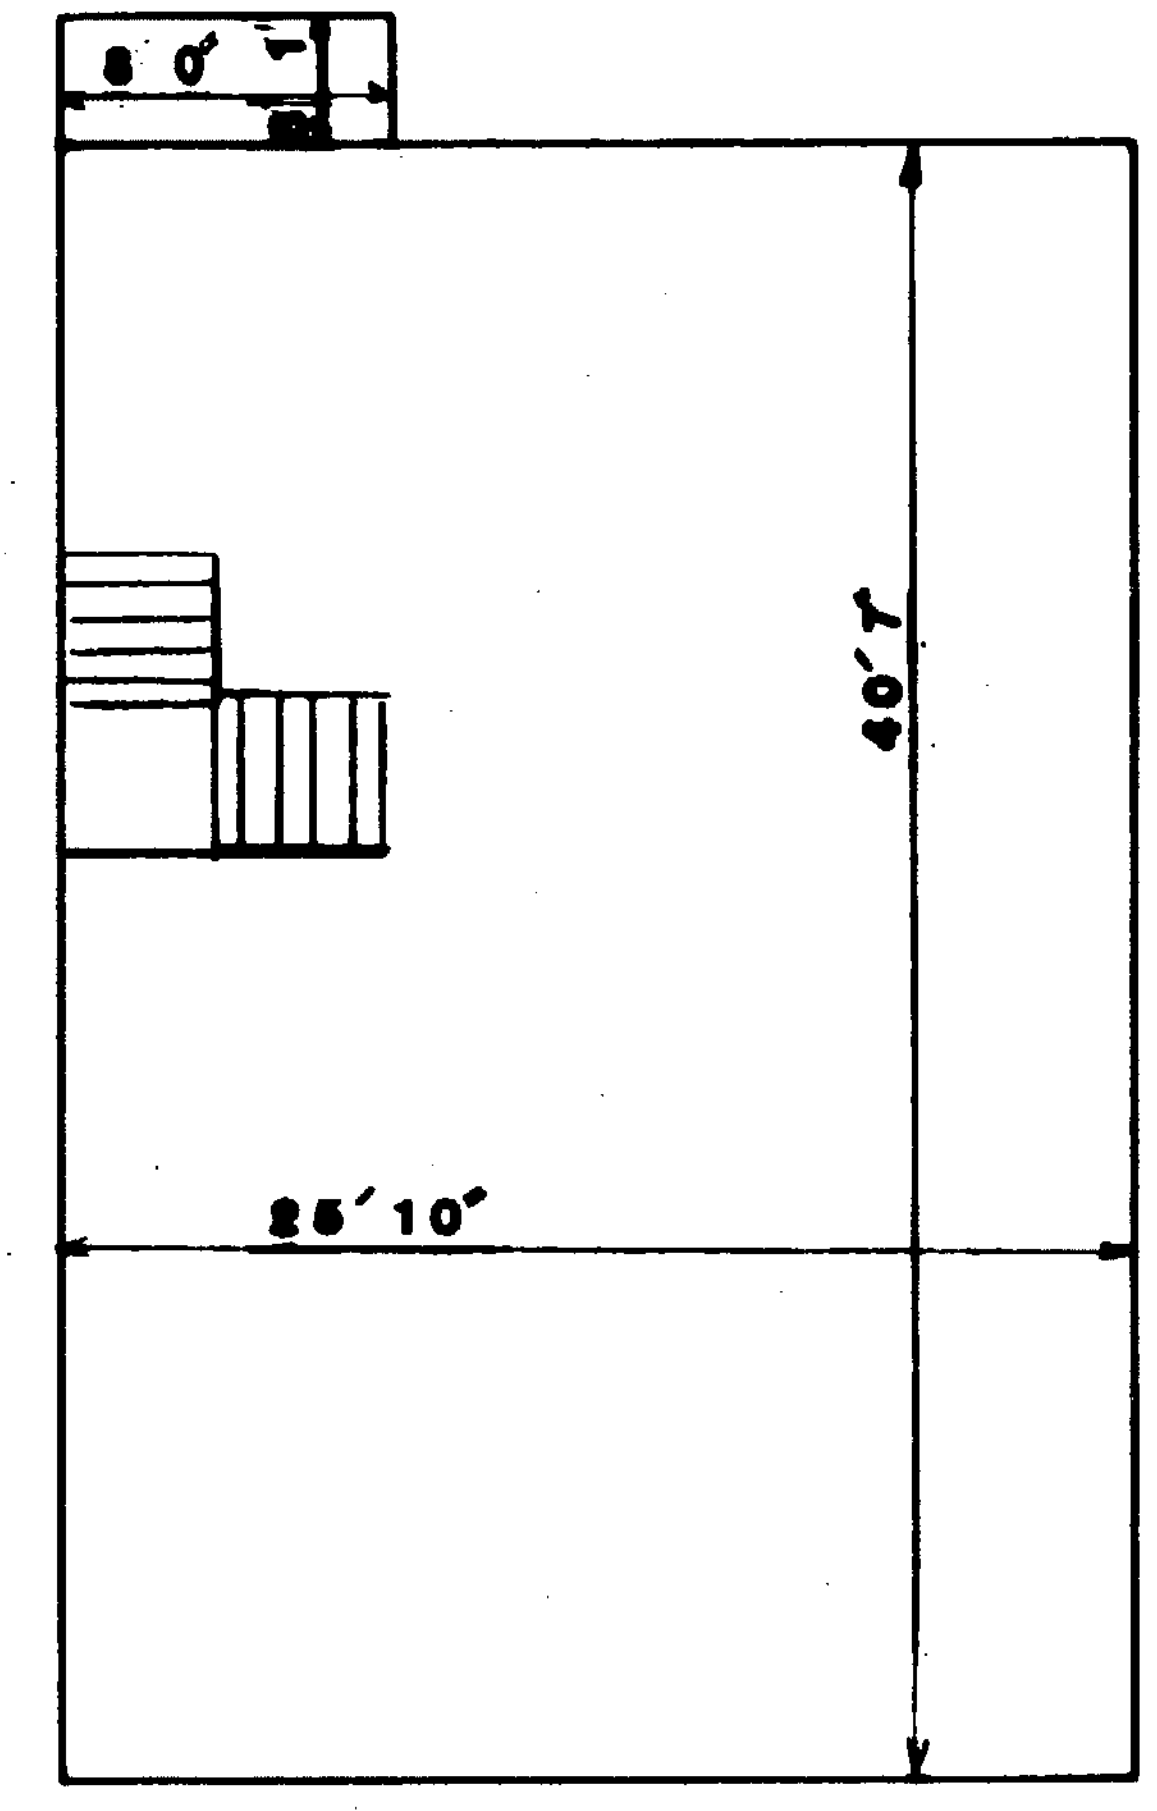

Basement

Per Plan For Unit 20

I the undersigned being the owner of the fee simple title to the real estate herein described, hereby consent to and join in the submission of said real estate to the condominium plan known as West Pointe Crossing Condominium.

William E. Harp
 Witness
Chadley
 Witness

Roby L. Roberts
 Roby L. Roberts

State of Ohio

Before me, the undersigned, a notary public in and for the said state, personally appeared Roby L. Roberts

and acknowledged that they are duly authorized to sign plat and that said signature is their free and voluntary act and deed. In testimony whereof, I hereunto set my hand and official seal this 3rd day of Dec., 1990.

Carl G. Hartman
 Notary Public, State of Ohio
 My Commission Expires: 11-11-92

Chadley
 Notary Public, State of Ohio
 My Commission Expires: 11-11-92


THE HANNUM I

Certification


The within drawings consisting of pages 1 and 2 of West Pointe Crossing Condominium Phase II contains 0.8978 acres as recorded in the Plat Records Clinton County, Ohio.

The measurements are certified correct and these drawings accurately show the buildings as constructed.

THE HANNUM II

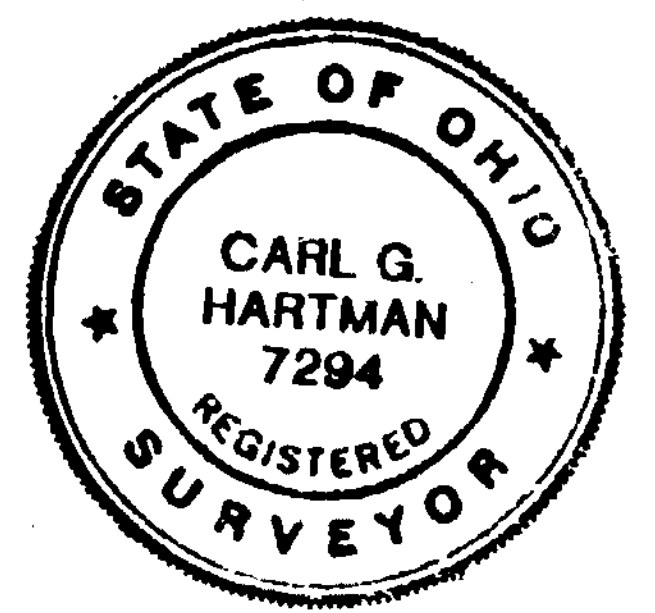

Carl G. Hartman
 Registered Land Surveyor
 #7294

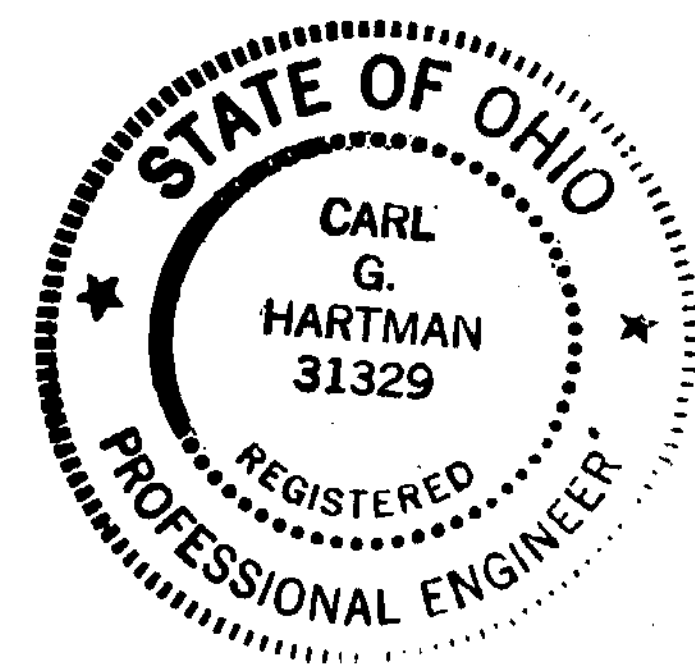

Carl G. Hartman
 Registered Professional Engineer
 #31329

EXHIBIT B-1 PAGE 2

C. C. HARTMAN & ASSOC., INC.
 ENGINEERING, ARCHITECTURE, PLANNING & SURVEYING
 514-A Ohio Pike
 Cincinnati, Ohio 45256
 (513) 528-1050

**WEST POINTE CROSSING
 CONDOMINIUM
 PHASE II**
 MILITARY SURVEY #157
 CITY OF WILMINGTON
 CLINTON COUNTY, OHIO

Date: November 1990
 Scale: 1/8" = 1'
 Sheet: 2 of 2
 Drawn By: JOL
 (2900pl2.dwg)
 Job No: CL-2.1